


LEGEND

----- 1680----	EXISTING INDEX CONTOUR (C.I.=5')
----- 1679----	EXISTING INTERMED. CONTOUR (C.I.=1')
=====	EXISTING ROAD
	RIPRAP
=====	MATCHLINE

SCALE (FEET)

100 0 100 200

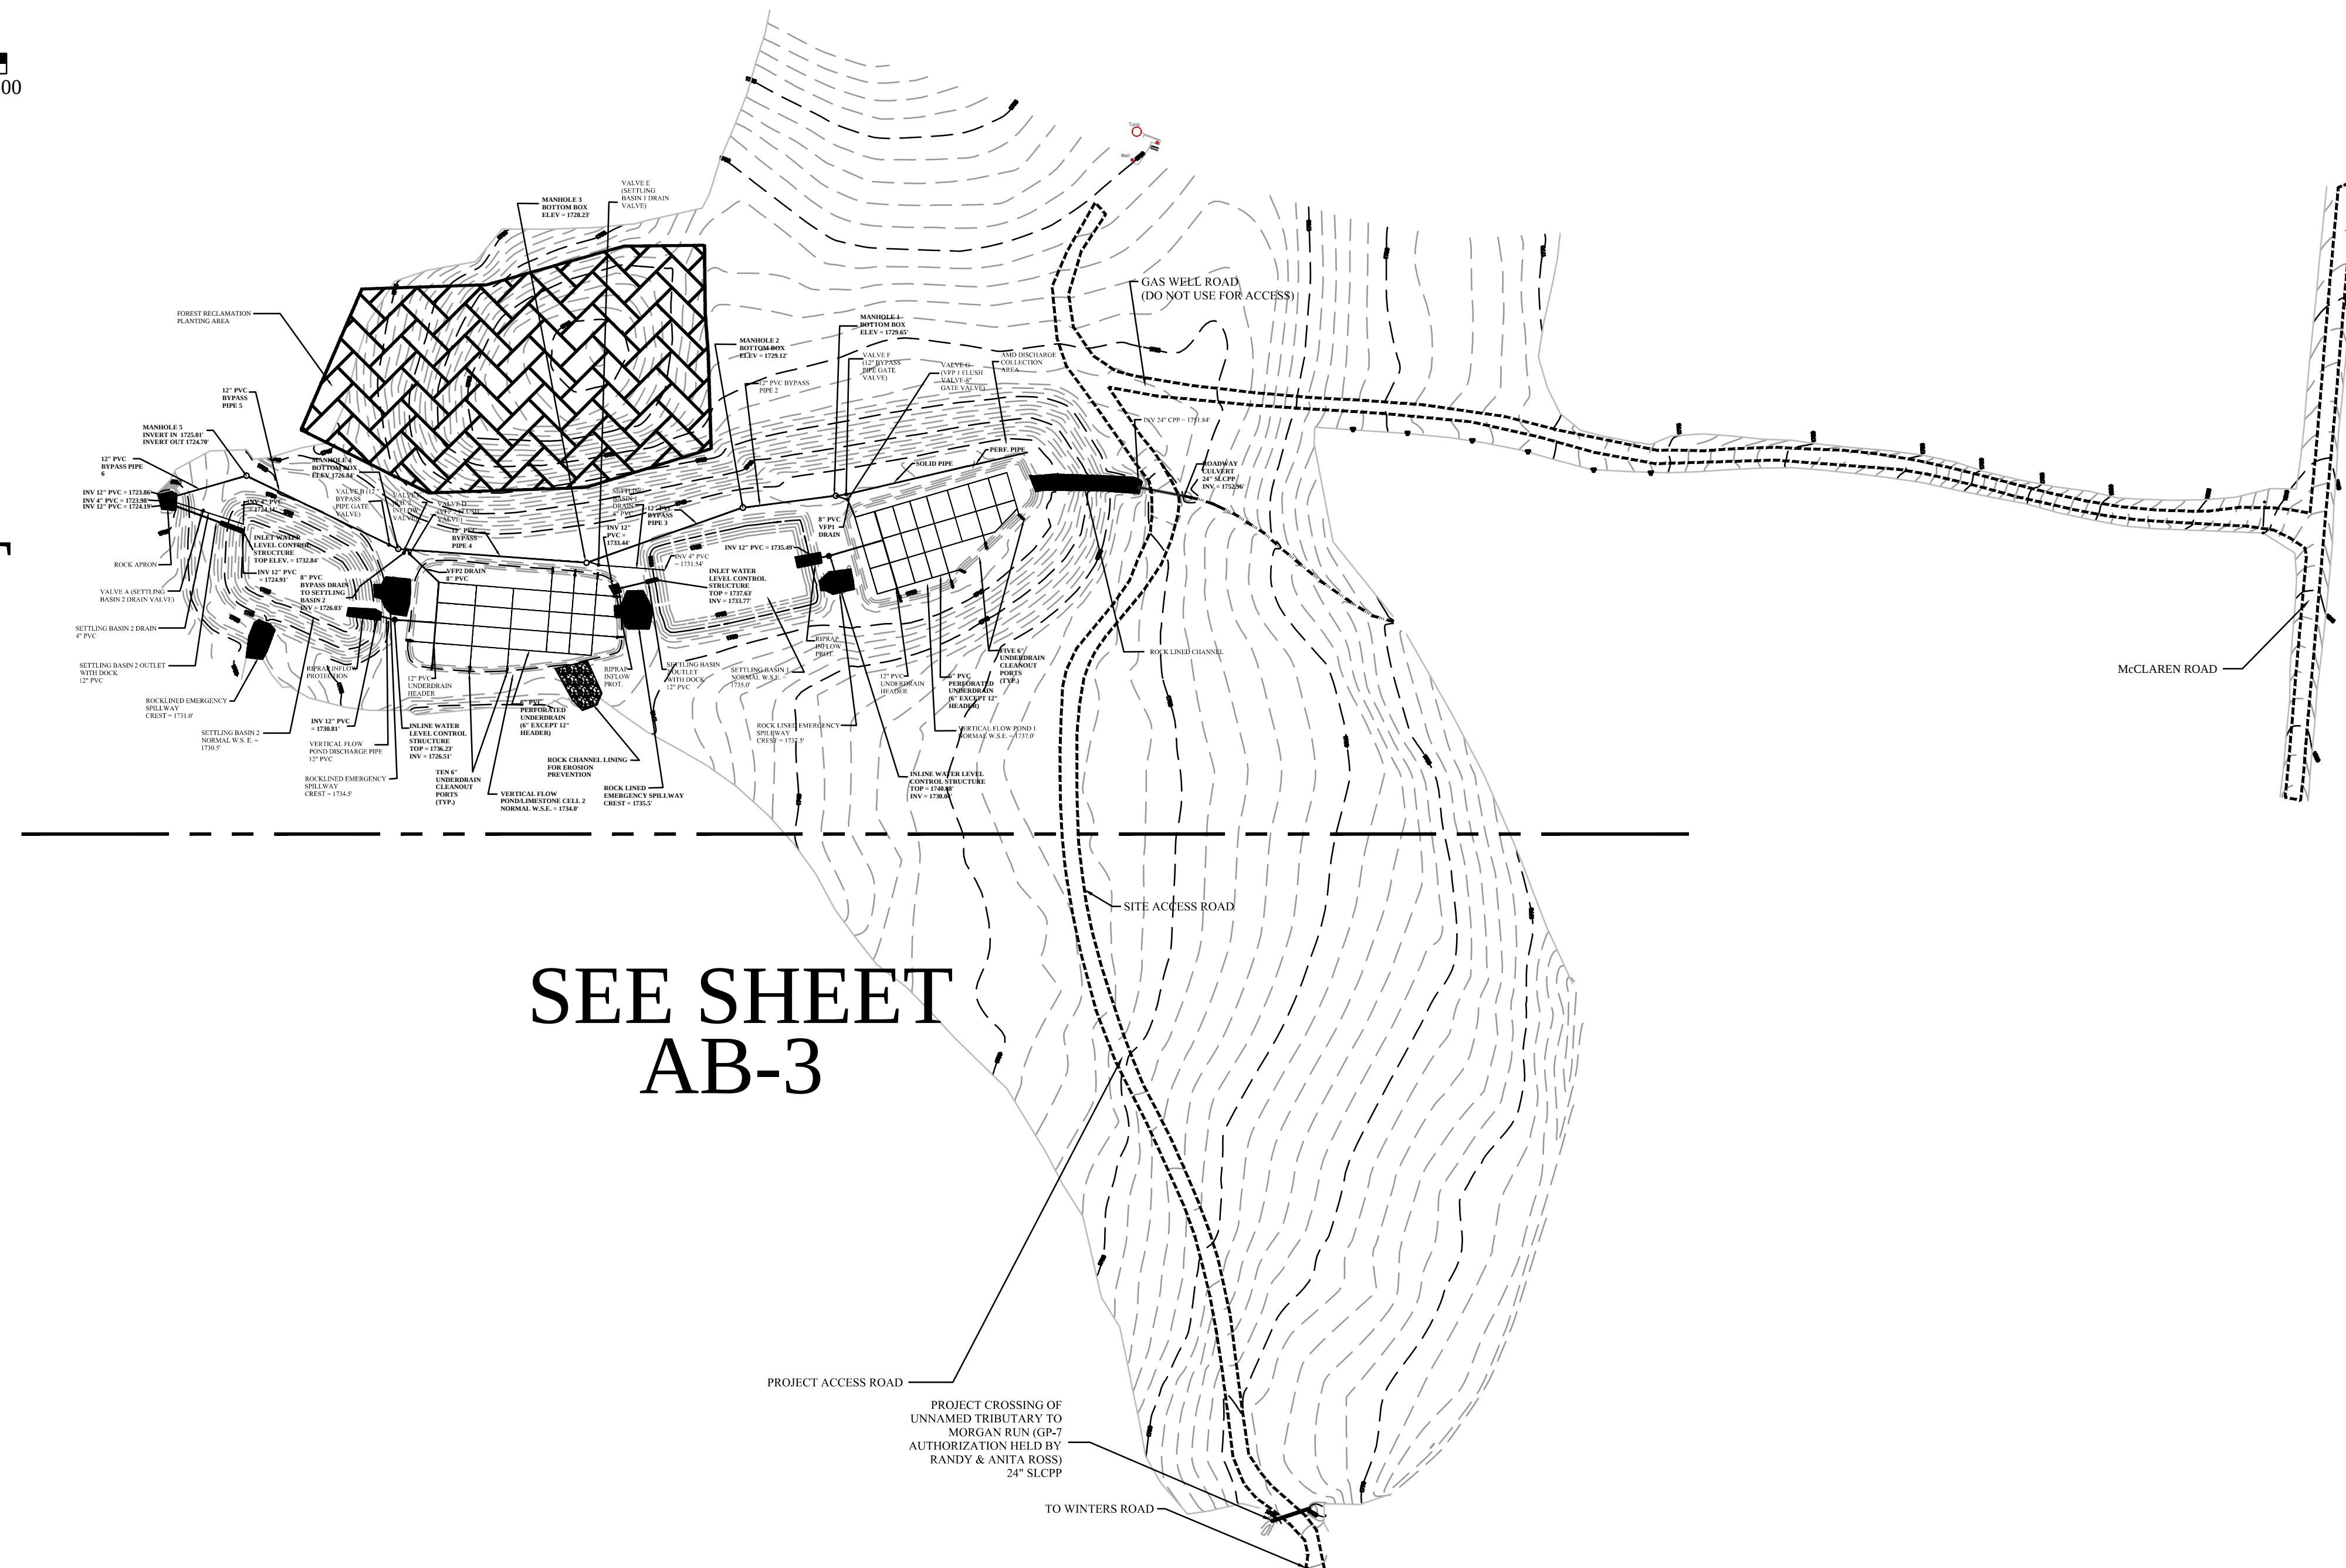

NOTES:

1. AS-BUILT SURVEY PREPARED BY
LAND AND MAPPING SERVICES, 230
NORTH SECOND STREET, CLEARFIELD,
PA, 16830, IN OCTOBER 2012.

PREPARED FOR:



1602 OREBED ROAD
MANSFIELD, PA 16933
PH: 570-662-8631

**MORGAN RUN ROSS
AMD TREATMENT SYSTEM
CONSTRUCTION AS BUILT**

E: INDEX OF AS BUILT DRAWINGS

PREPARED BY:




107 COAL STREET
MILLS, PENNSYLVANIA 16666
PHONE: (814) 339-6998

SCALE:
1" = 100'

FEBRUARY 7, 2013

THE INFORMATION CONTAINED HEREON
MAY NOT BE USED OR COPIED WITHOUT
WRITTEN PERMISSION OF THE SIGNING
ENGINEER

SEAL:

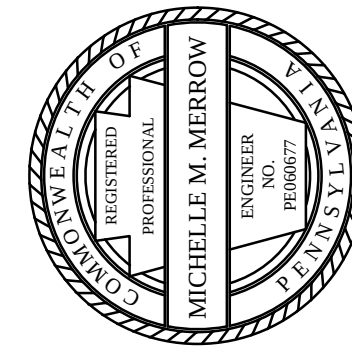

Michelle M. Merrow

SHEET NO.

AB-1

10F3