


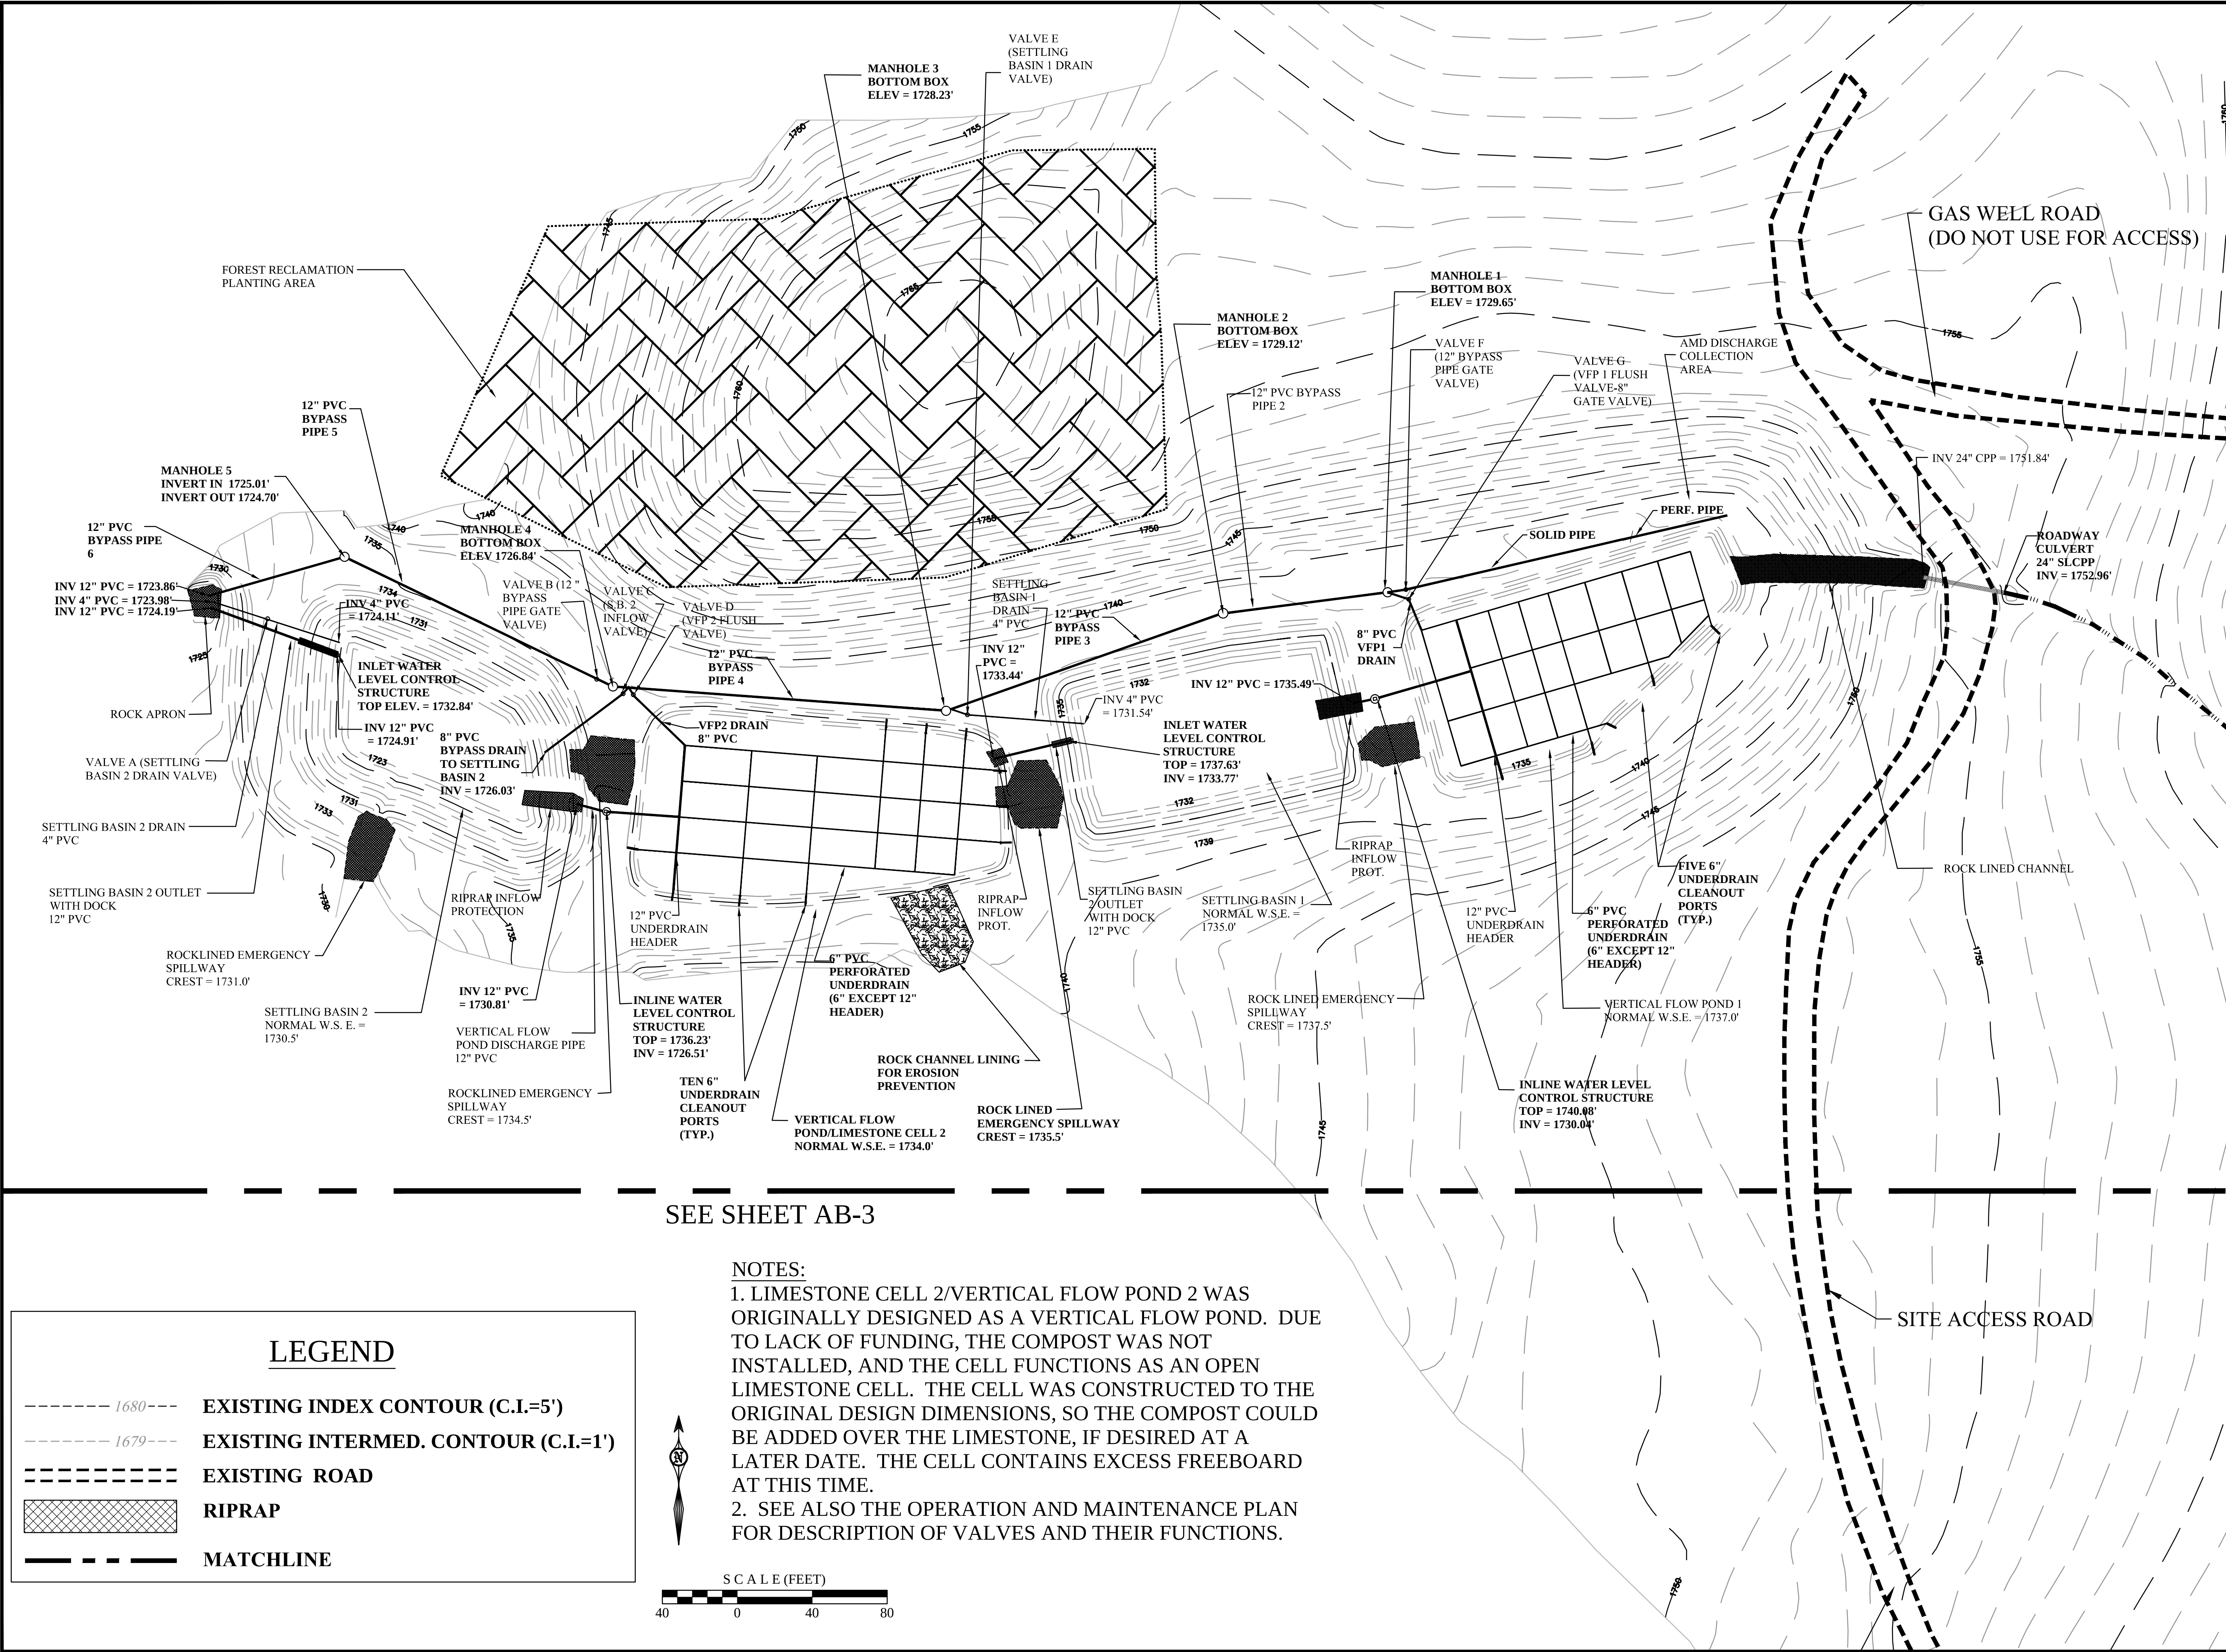

SHEET NO.

AB-2

2 OF 3

REGISTERED PROFESSIONAL ENGINEER

MICHELLE M. MERROW

PE060677

THE INFORMATION CONTAINED HEREON MAY NOT BE USED OR COPIED WITHOUT WRITTEN PERMISSION OF THE SIGNING ENGINEER.

SEAL:

NO.

DATE

DESCRIPTION

REVISIONS

PREPARED BY:

ALDER RUN ENGINEERING

107 COAL STREET
OSCEOLA MILLS, PENNSYLVANIA 16666
PHONE: (814) 339-6998

DATE:

JANUARY 7, 2013

SCALE:

1" = 40'

PROJECT:

MORGAN RUN ROSS
AMD TREATMENT SYSTEM
CONSTRUCTION AS BUILT

DECATUR TOWNSHIP, CLEARFIELD COUNTY, PA

PREPARED FOR:

new miles of
Blue Stream
NABS

1602 OREBED ROAD
MANSFIELD, PA 16933
PH: 570-662-8631