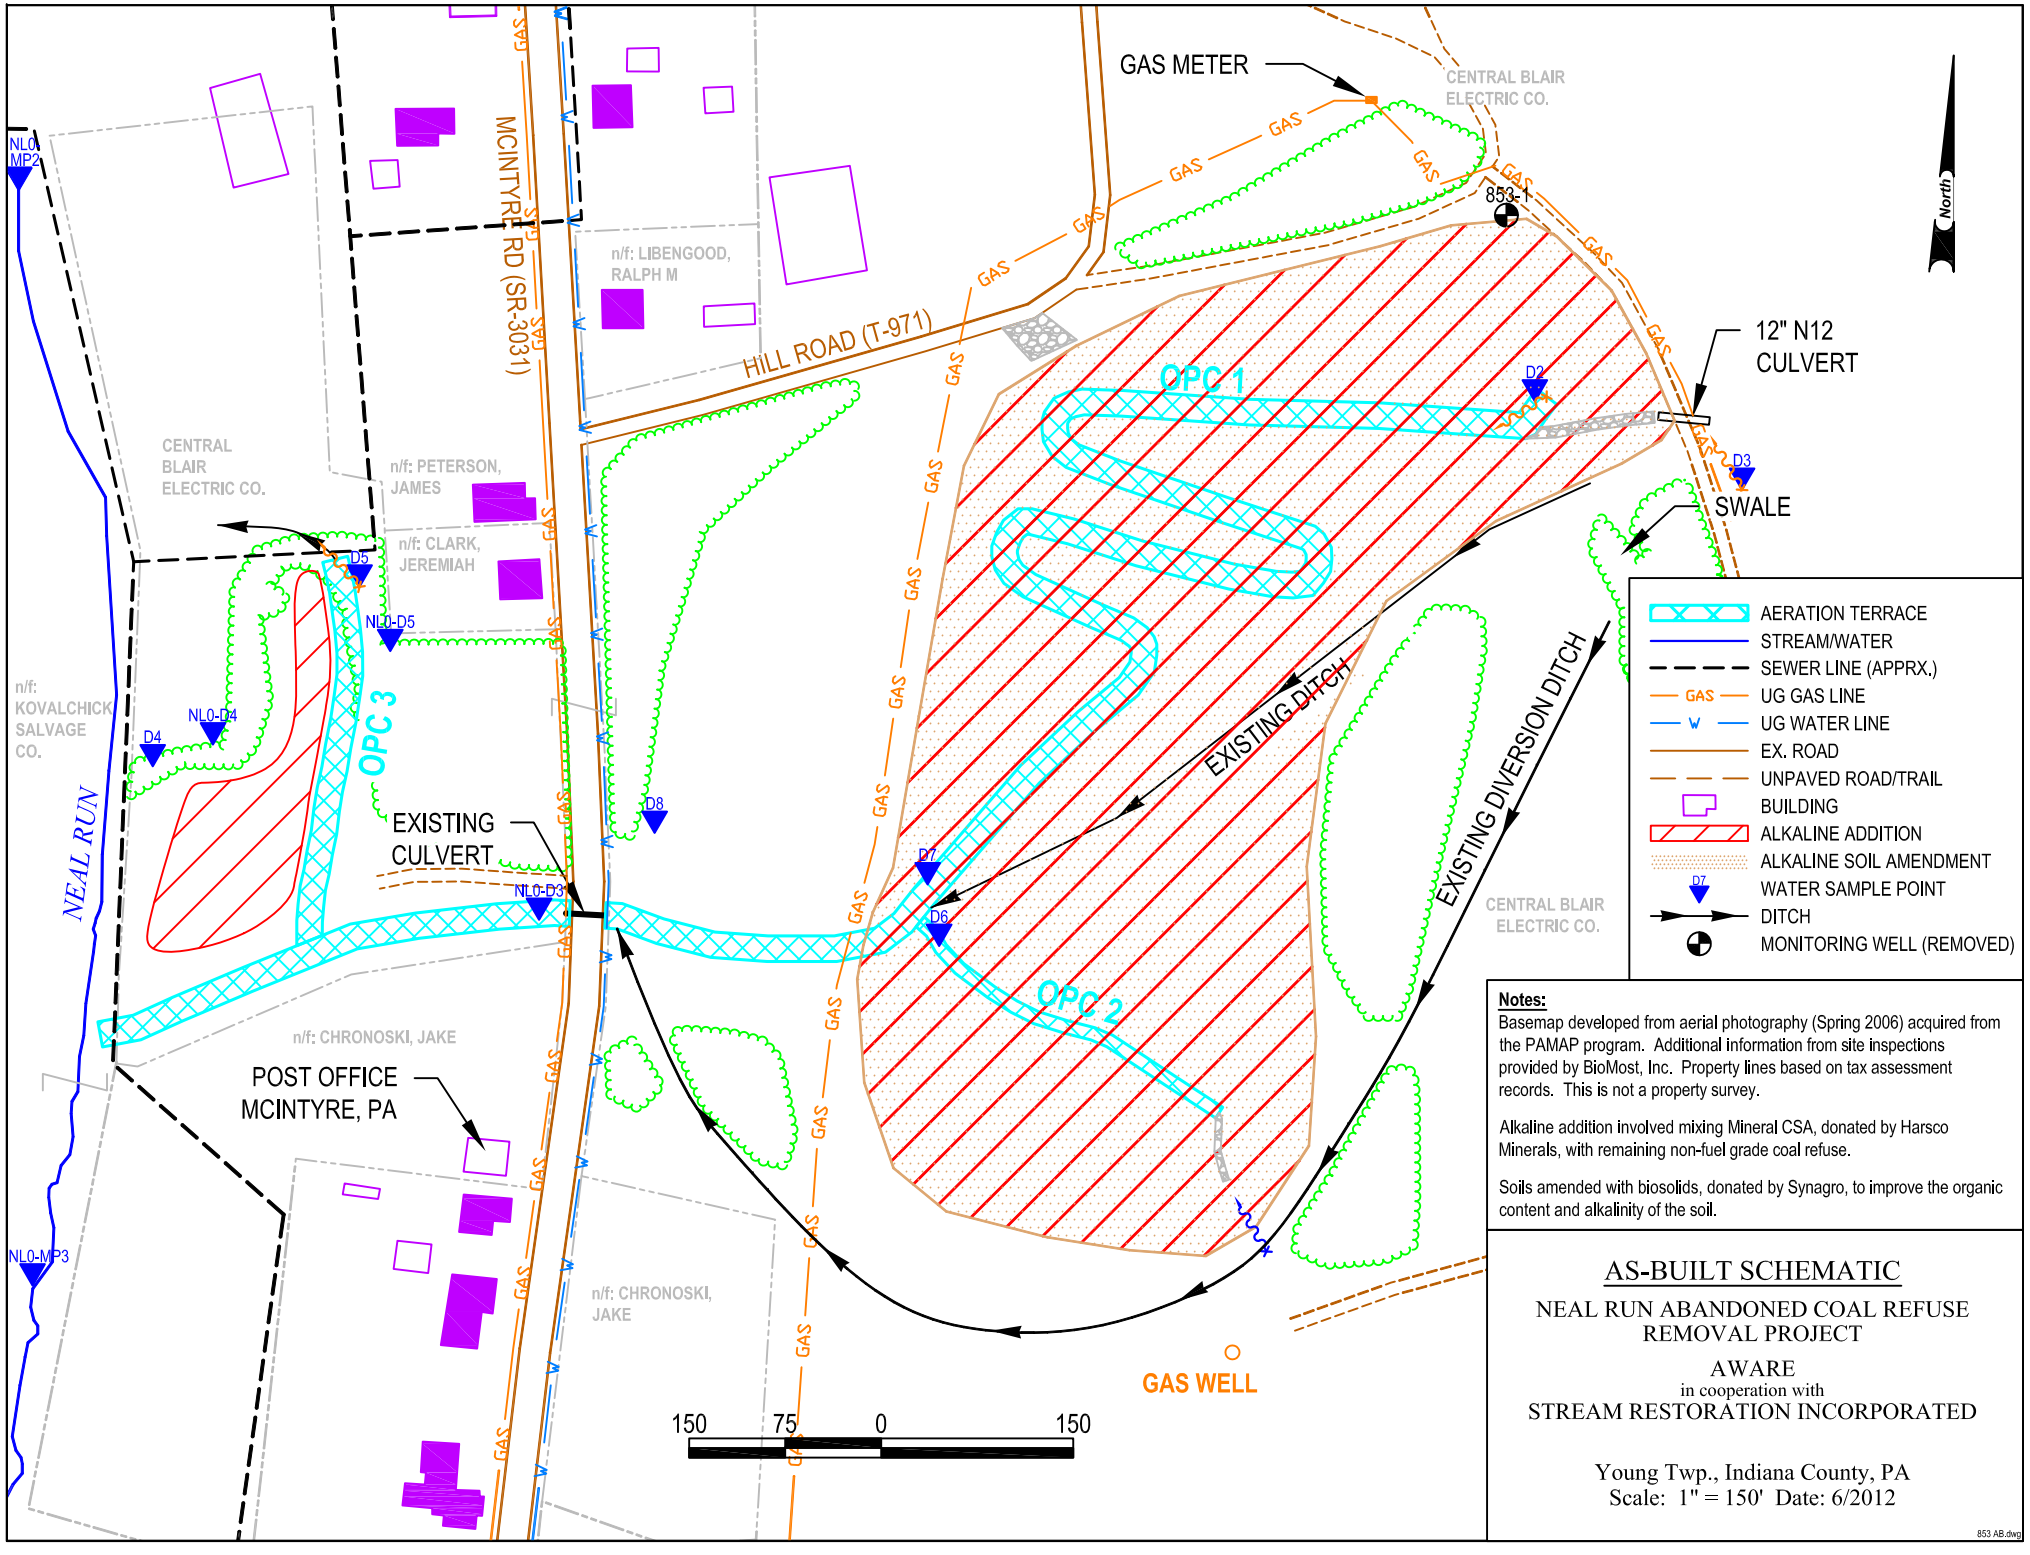

Notes:

Basemap developed from aerial photography (Spring 2006) acquired from the PAMAP program. Additional information from site inspections provided by BioMost, Inc. Property lines based on tax assessment records. This is not a property survey.

Alkaline addition involved mixing Mineral CSA, donated by Harsco Minerals, with remaining non-fuel grade coal refuse.

Soils amended with biosolids, donated by Synagro, to improve the organic content and alkalinity of the soil.

AS-BUILT SCHEMATIC

NEAL RUN ABANDONED COAL REFUSE REMOVAL PROJECT

AWARE
in cooperation with
STREAM RESTORATION INCORPORATED

Young Twp., Indiana County, PA
Scale: 1" = 150' Date: 6/2012

853 AB.dwg